



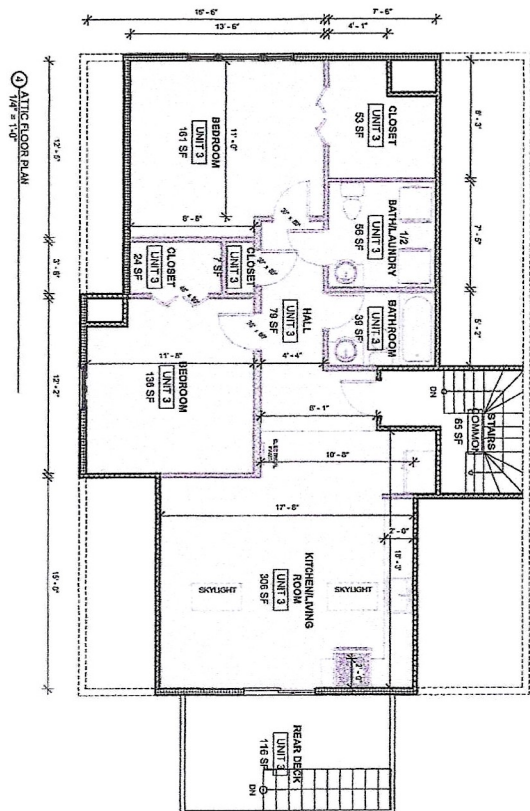

④ ATTIC FLOOR PLAN
1/4" = 1'-0"

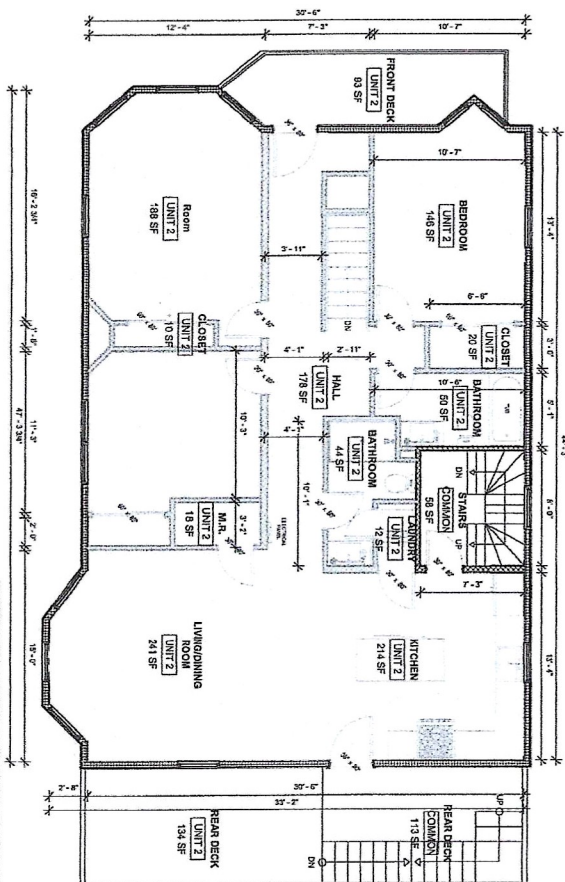

③ SECOND FLOOR PLAN
1/4" = 1'-0"


PROPOSED GROSS BUILDING	
FAR	GS/PILOT AREA
Name	Area
COMMON	209 SF
UNIT 1	1261 SF
UNIT 2	1379 SF
UNIT 3	894 SF
TOTAL	3743 SF

I CERTIFY THAT THIS PLAN HAS BEEN PREPARED IN CONFORMANCE WITH THE RULES AND REGULATIONS OF THE REGISTERS OF DEEDS OF THE COMMONWEALTH OF MASSACHUSETTS.

I CERTIFY THAT THIS PLAN FULLY AND ACCURATELY REFLECTS THE LOCATION AND DIMENSIONS OF THE BUILDING AS BUILT, AND FULLY LISTS THE UNITS COMPOSED THEREIN, AND FURTHER FULLY AND ACCURATELY REFLECTS LOCATES, AND PROMOTES THE DIMENSIONS OF ANY DEFECT, DEFECT LOCATES, AND FURTHER FULLY AND ACCURATELY REFLECTS LOCATES, AND PROMOTES THE DIMENSIONS OF THE CONVEYED AND PLANNED OF ANY BUILDING.

I CERTIFY THAT THIS PLAN FULLY AND ACCURATELY REFLECTS THE LOCATION AND DIMENSIONS OF THE BUILDING AS BUILT, AND FULLY LISTS THE UNITS COMPOSED THEREIN, AND FURTHER FULLY AND ACCURATELY REFLECTS LOCATES, AND PROMOTES THE DIMENSIONS OF THE CONVEYED AND PLANNED OF ANY BUILDING.

DATE 02/04/2013

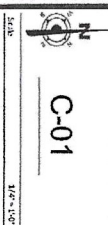

59 WENHAM STREET
BOSTON, MA

<https://rangelplanningdesign.com>
26 NORWOOD STREET,
EVERETT, MA
02149
(339) 440-7943

X
FRANGEL

PROPOSED FLOOR
PLAN

[illegible]