


# WEST

## JONHSON COUNTY, NEB.

SURVEYED AND DRAWN BY W. L. DUNLAP,  
County Surveyor.

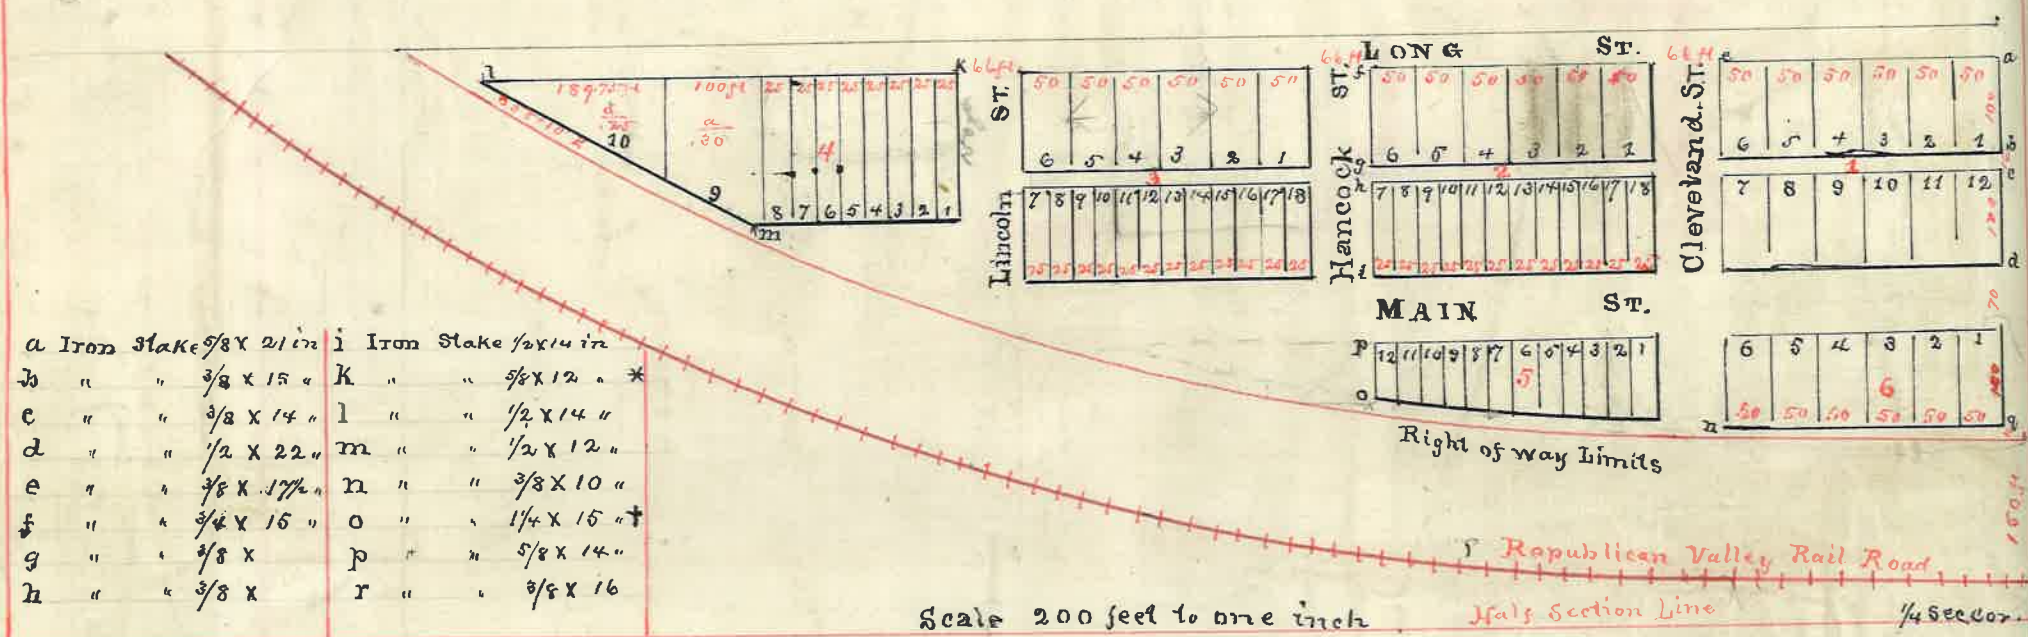

a Iron Stake 3/8 x 21 in	i Iron Stake 1/2 x 14 in
b " " 3/8 x 15 "	k " " 5/8 x 12 " *
c " " 3/8 x 14 "	l " " 1/2 x 14 "
d " " 1/2 x 22 "	m " " 1/2 x 12 "
e " " 3/8 x 17 1/2 "	n " " 3/8 x 10 "
f " " 3/4 x 16 "	o " " 1 1/4 x 15 " †
g " " 3/8 x	p " " 5/8 x 14 "
h " " 3/8 x	r " " 3/8 x 16 "

\* Flattened with hole in top  
† Head broke off one side



Hulda <sup>and</sup> H. H. Long <sup>and</sup> wife

TO  
The Public.

FILED FEB 27 1886

At 1:45 o'clock P. M.  
Pl. SE<sup>1/4</sup> of NE<sup>1/4</sup> of 31-5-10.

I hereby certify that in the month of February 1886, I surveyed the town site of Vesta situated on a part of the South East quarter of the North East quarter of Section Thirty-one 31 in Town Five 5 North of Range Ten 10 East of the Sixth Principal Meridian in Johnson County Nebraska as shown

by the foregoing map which is drawn to a scale of Two Hundred feet to one inch. The Blocks and Lots are numbered and their dimensions are expressed by the figures thereon, and the width of streets and alleys are designated thereon in red ink in feet and decimals.

Burr oak stakes are well driven down at the corner of all Lots and Stones and iron stakes at points named on the map.

Witness my hand this 27th day of February 1886,

W. D. Dunlap, County Surveyor.

This is to certify that the foregoing subdivisions of a part of the South East quarter of the North East quarter of Section Thirty-one in Town Five North of Range Ten East in Johnson County Nebraska, as appears on this plat is with the free consent and in accordance with the desire of the undersigned owners and proprietors of the said premises

Witness our hands this 27th day of February 1886.

In presence of  
J. M. Nelson,  
W. D. Dunlap.

Hulda <sup>hus</sup> & Long,  
<sup>wife</sup>  
Kelona Long,  
Ethelind Long,

State of Nebraska, } ss.  
Johnson County }  
On this 27th day of February 1886, personally before me J. M. Nelson, a Justice of the Peace, duly elected and qualified in and for said County came H. H. Long and Ethelind Long husband and wife <sup>and</sup> Hulda H. Long, personally known to me to be the identical persons who executed the foregoing Instrument as grantors, and they severally acknowledged the same to be their voluntary act and deed for the purposes therein expressed.

Witness my hand and official signature at Vesta Nebraska  
the day and date last above written.

J. M. Nelson,  
Justice of the Peace.